


5TH FLOOR AVAILABILITY

Suite 500

Approximately
11,014 RSF

As-Built Plan

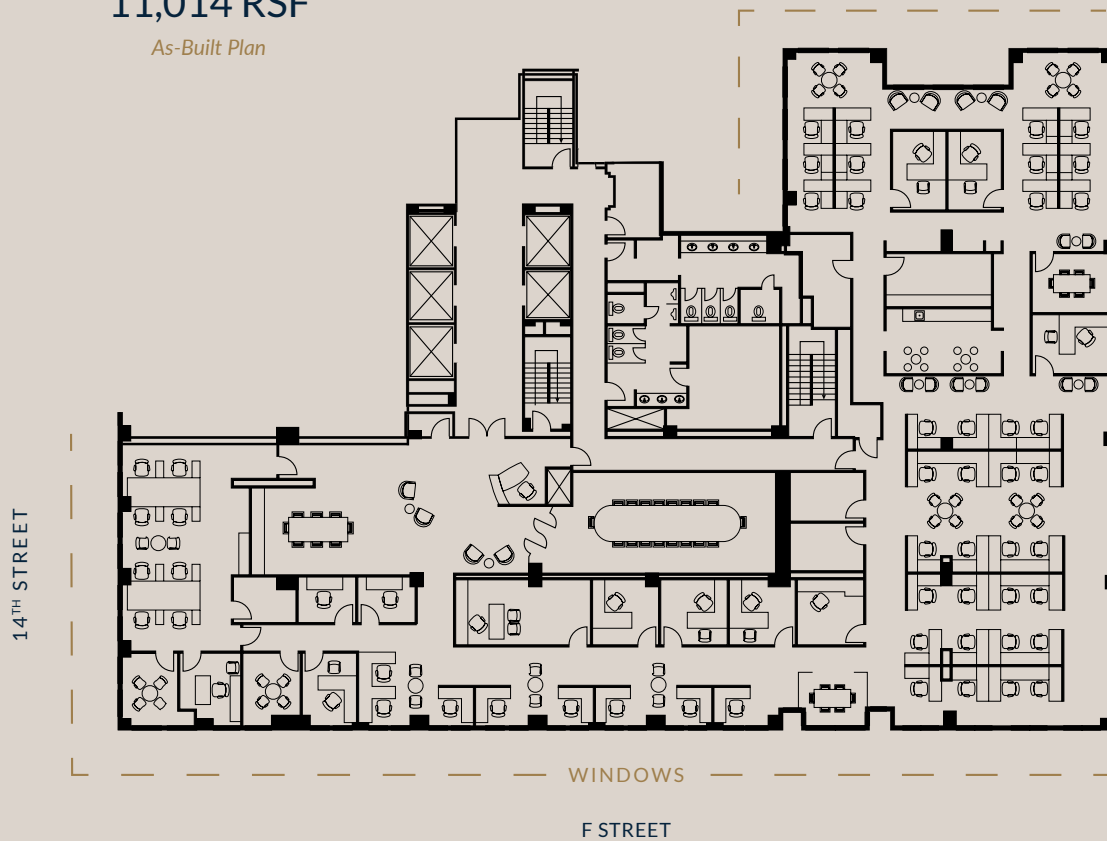

**FOR LEASING,
CONTACT:**

Laurie McMahon
Laurie.McMahon@cushwake.com
+1 202 266 1185

James Collins
James.Collins@cushwake.com
+1 202 266 1188

Ellison Cook
Ellison.Cook@cushwake.com
+1 703 847 2735




5TH FLOOR AVAILABILITY

Suite 500

Approximately

11,014 RSF

Shell Condition

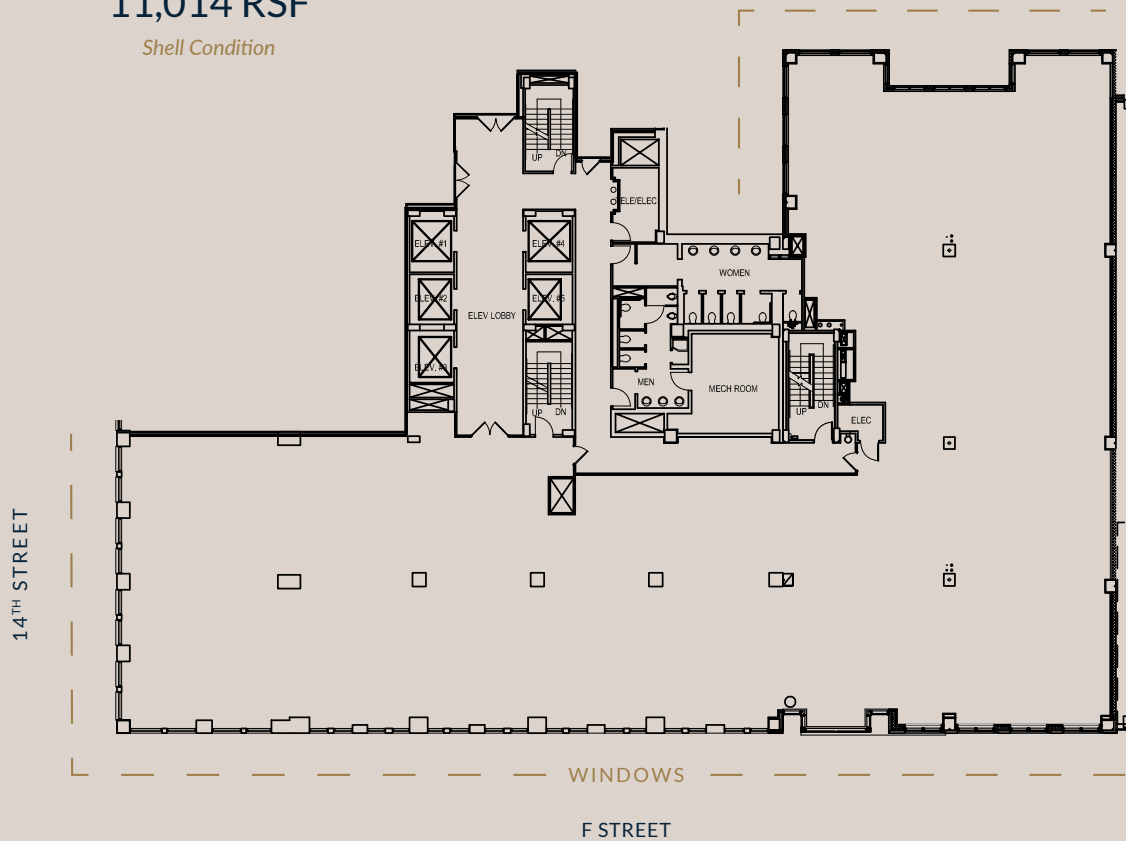

**FOR LEASING,
CONTACT:**

Laurie McMahon
Laurie.McMahon@cushwake.com
+1 202 266 1185

James Collins
James.Collins@cushwake.com
+1 202 266 1188

Ellison Cook
Ellison.Cook@cushwake.com
+1 703 847 2735

